CORNER RECORD

Agency Index BK 136 PG 12
Document Number CR 14707

City of EDEN TOWNSHIP County of ALAMEDA, California

Brief Legal Description MONUMENT LOCATED WITHIN GREENRIDGE RD AT HIGHWOOD ROAD.

CORNER TYPE

Government Corner	☐	Control	☒
Meander	☐	Property	☐
Rancho	☐	Other	☐

Date of Survey 9/3/2020

COORDINATES (Optional)

N. _____ E. _____

Elevation _____

Units Metric ☐ U.S. Survey Foot ☐

Horizontal Datum _____

Zone _____ Epoch Date _____

Vertical Datum _____

☐ Complies with Public Resources Code §§8801-8819

☐ Complies with Public Resources Code §§8890-8902

PLS Act Ref:	☐ 8765 (d)	☒ 8771	☐ 8773	☐ Other:
Corner/ Monument:	☒ Left as found	☐ Established	☐ Rebuilt	☒ Pre-Construction
	☐ Found and tagged	☐ Reestablished	☒ Referenced	☐ Post-Construction

Narrative of corner identified and monument as found, set, reset, replaced, or removed:

☐ See sheet #2 for description (s):

FOUND 1/8" PIN IN CONCRETE IN MONUMENT WELL.

FOUND AND SET POINTS AS SHOWN ON PAGE 2.
THIS POINT WAS REFERENCED PRIOR TO A CONSTRUCTION PROJECT IN THE VICINITY.
THE TIES SHOWN HEREON ARE FOR THE PURPOSE OF PERPETUATING FOUND MONUMENTATION.
NO CLAIM IS MADE AS TO THE RELATIONSHIP OF THE POINTS OR LINES SHOWN HEREON TO TRUE BOUNDARY LOCATION.

SURVEYOR'S STATEMENT

This Corner Record was prepared by me or under my direction in conformance with the Professional Land Surveyors' Act on SEPTEMBER 3, 2020.

Signed _____ P.L.S. or ~~R.C.E. No.~~ 8525

SCOTT V. CUNHA

LICENSED LAND SURVEYOR
SCOTT V. CUNHA
NO. 8525
STATE OF CALIFORNIA

COUNTY SURVEYOR'S STATEMENT

This Corner Record was received _____, _____

and examined and filed OCT 21 2020, _____.

Signed _____ P.L.S. or ~~R.C.E. No.~~ 7010

Title COUNTY SURVEYOR

County Surveyor's Comment

LICENSED LAND SURVEYOR
D. IAN WILSON
No. 7010
STATE OF CALIFORNIA

SCALE: 1"=30'

LEGEND

- ◉ FOUND 1/8" PIN IN MONUMENT WELL
- ✕ SET NAIL AND TAG IN CURB STAMPED "TOWILL RP"
- AA##A# ALAMEDA COUNTY MONUMENT ID
- 19592 REFERENCE STREET ADDRESS

ALL MEASUREMENTS ARE IN U.S. SURVEY FOOT AND DECIMAL THEREOF

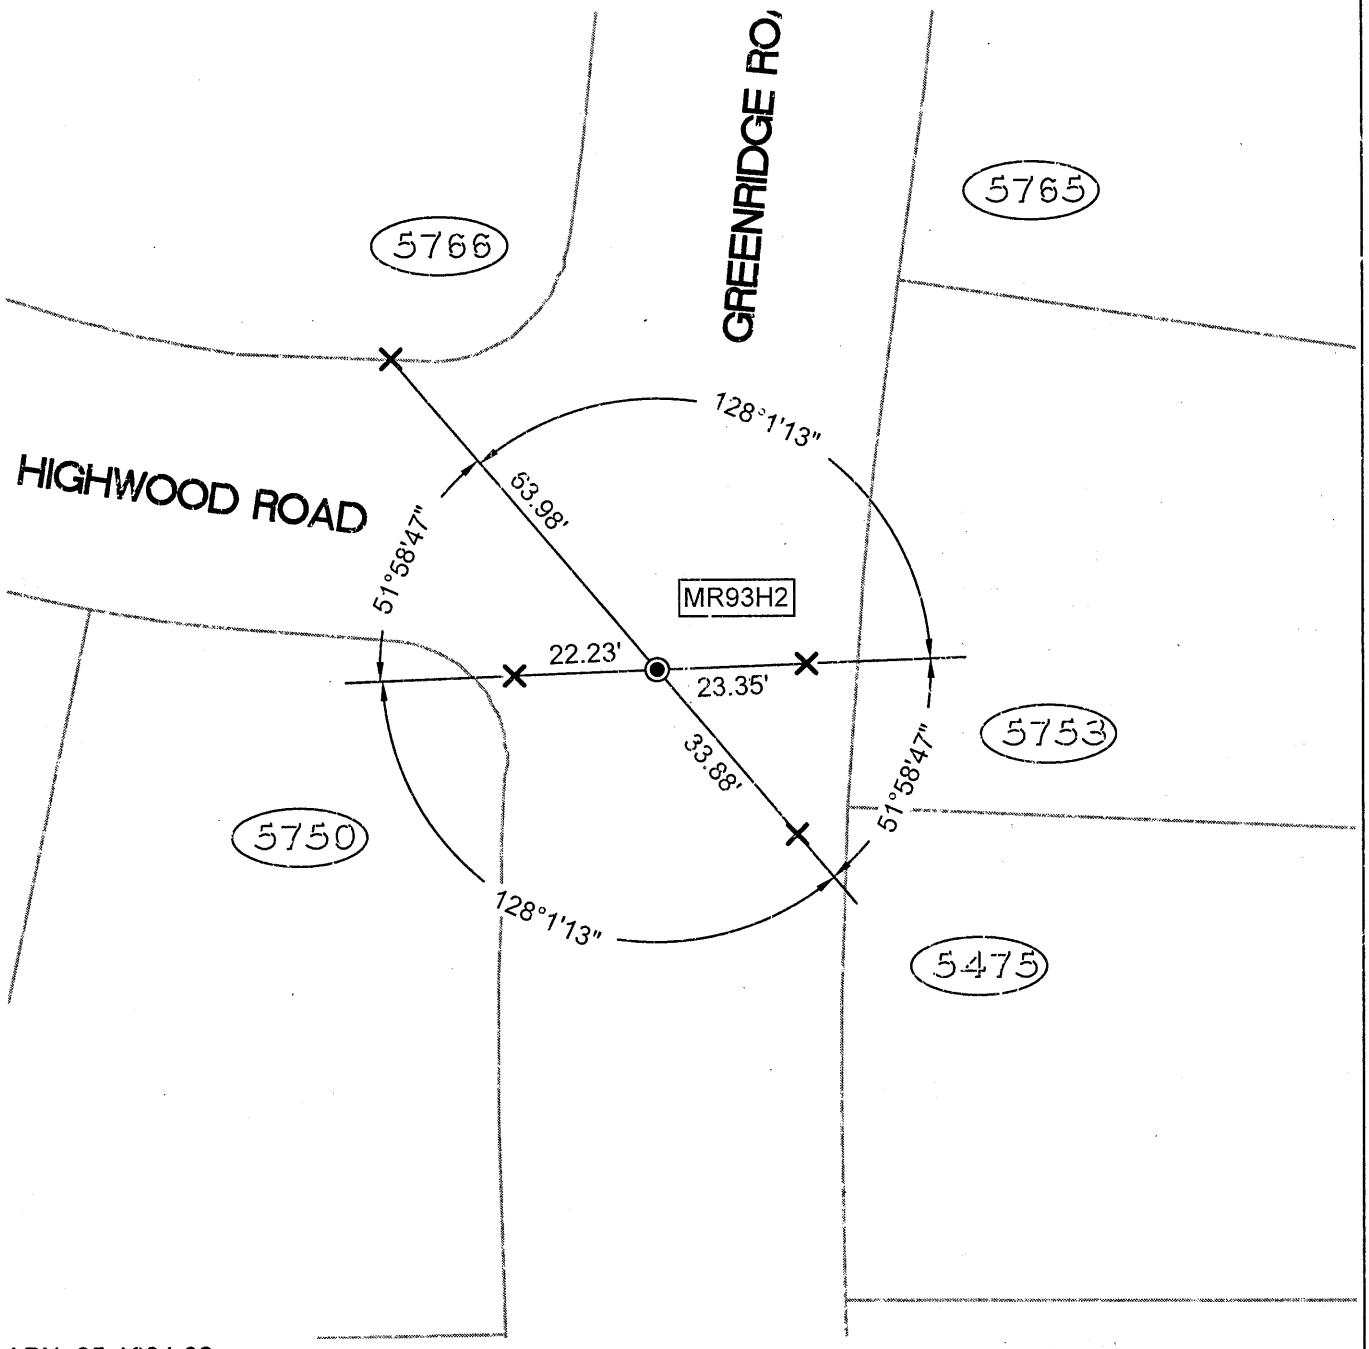

APN: 85-1604-38

16587-Green_Rd-CR-15